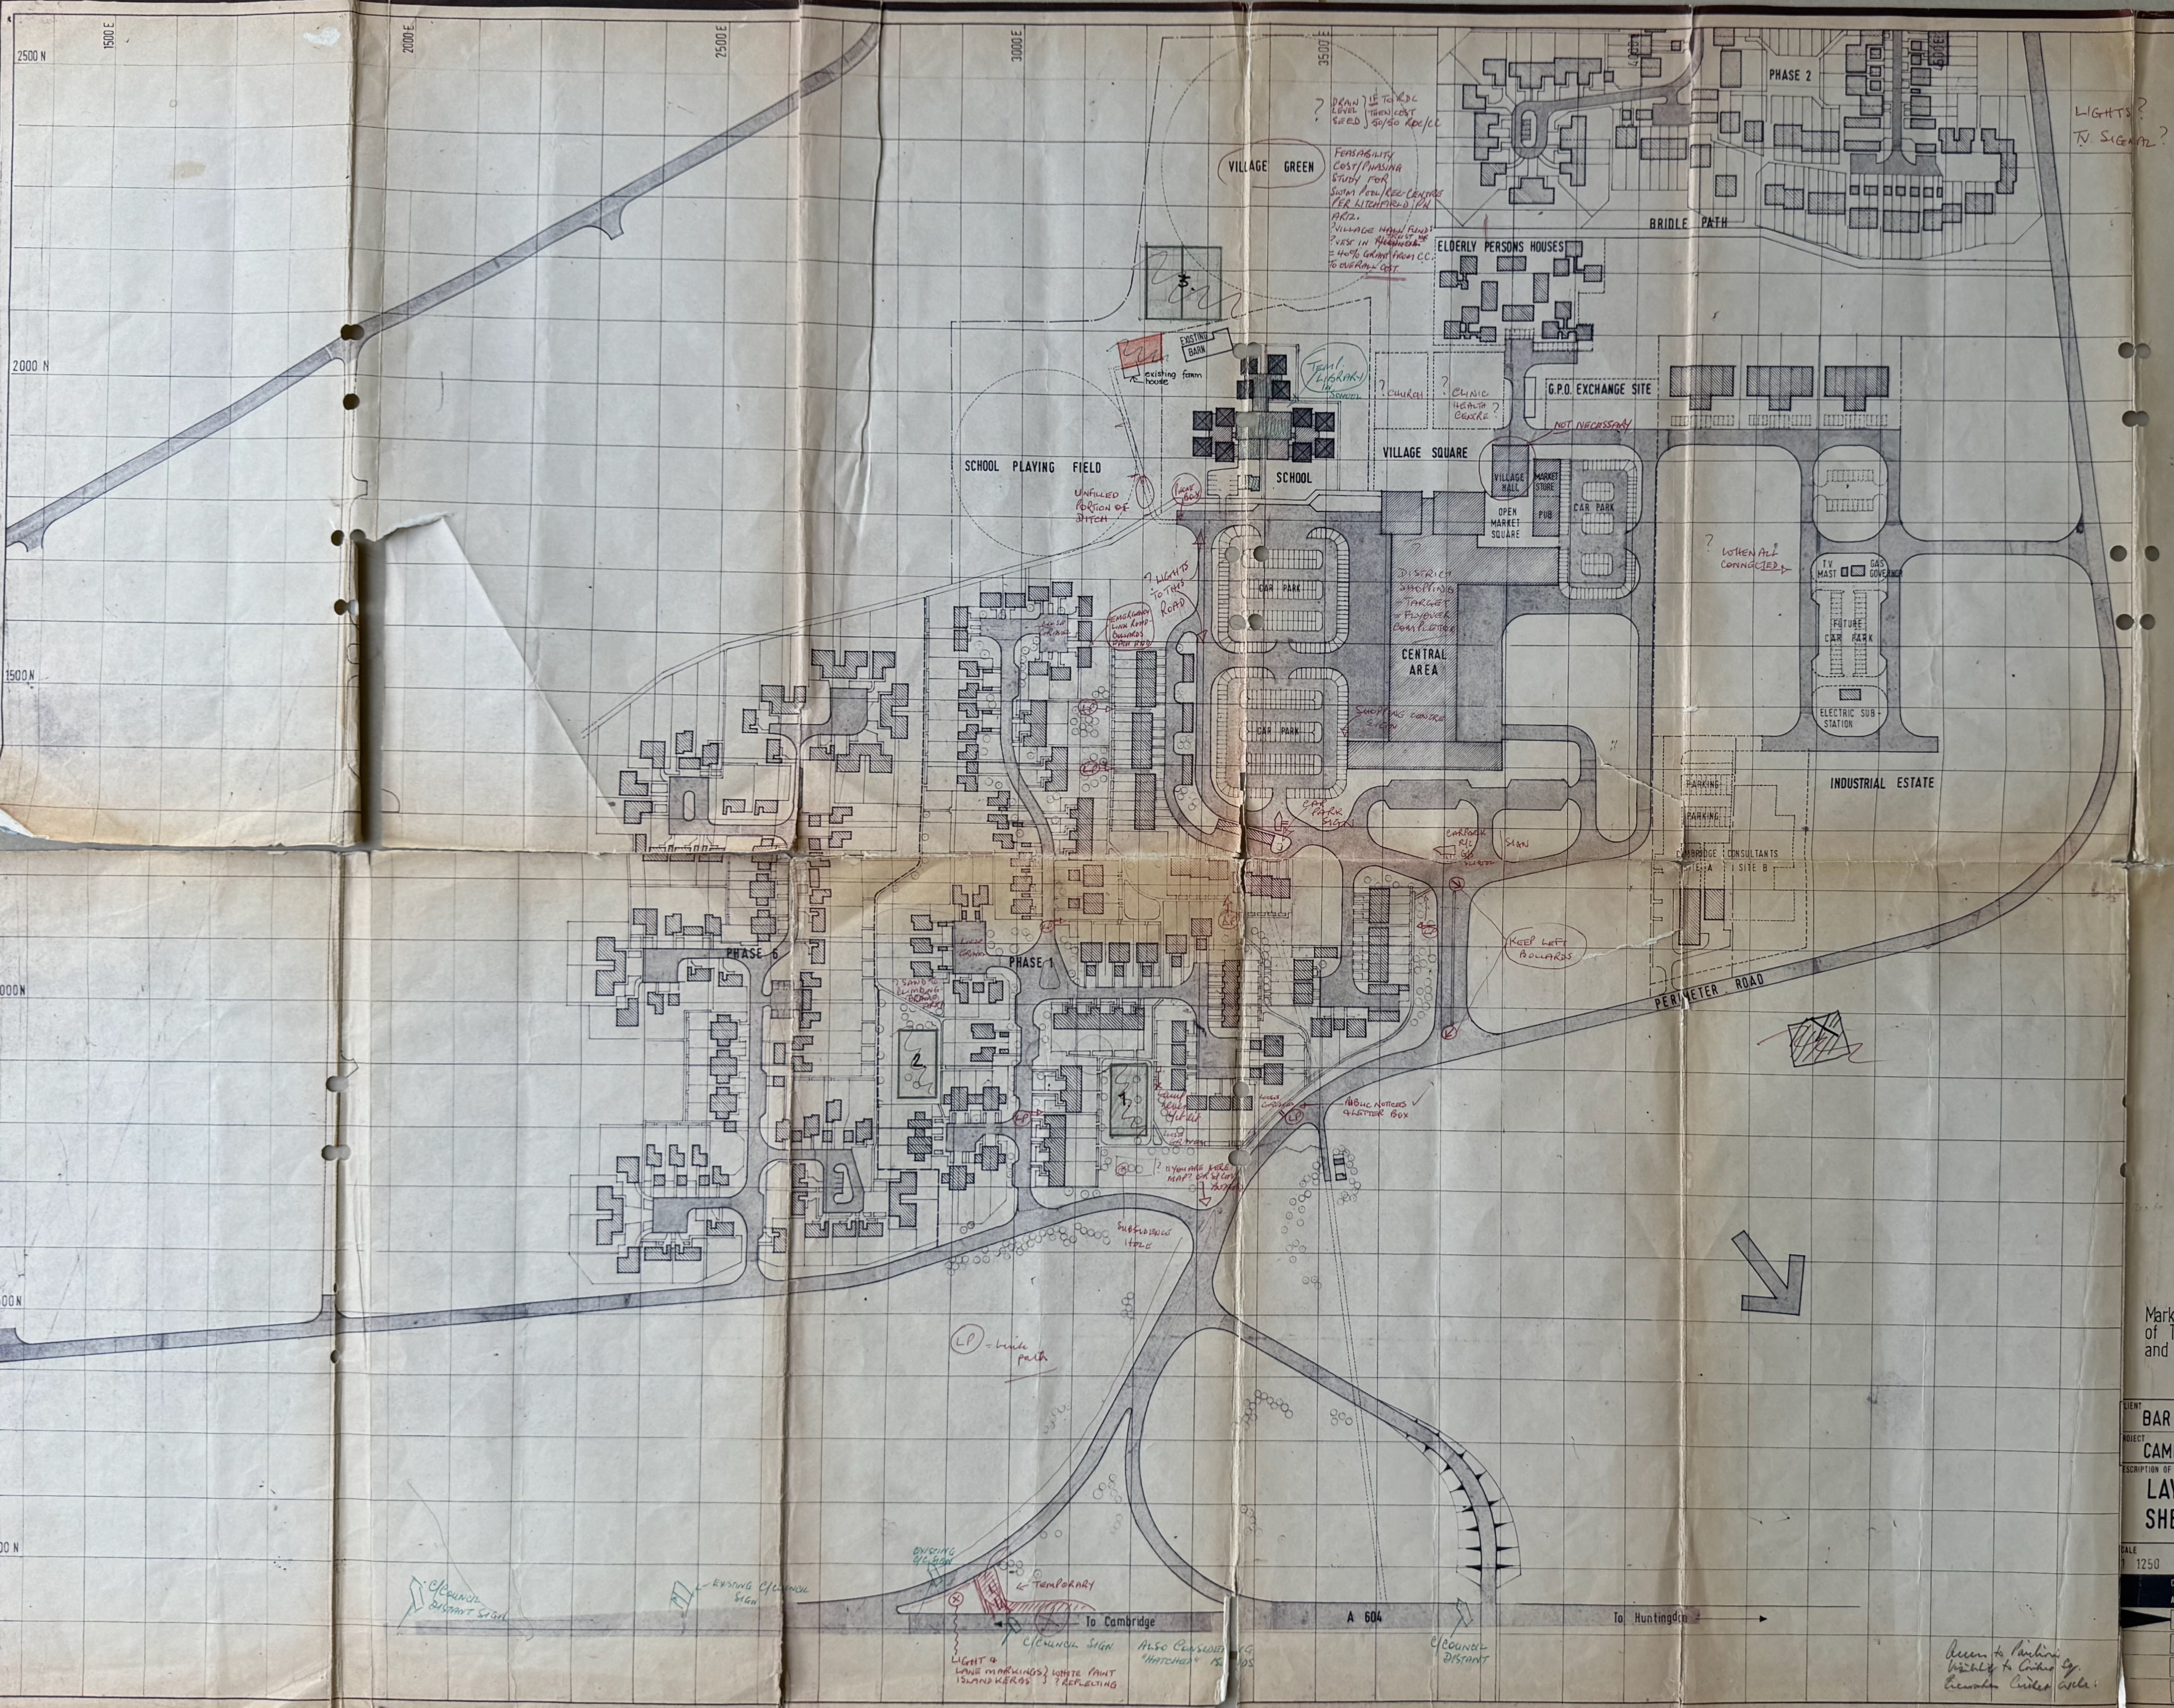

~~Marked up to show position
of Tennis Courts
and Sports Pavilion~~ NO !!!

CLIENT
BAR HILL DEVELOPMENTS LTD

PROJECT
CAMBRIDGE BAR HILL VILLAGE

DESCRIPTION OF DRAWING
LAYOUT PLAN
SHEET 1

DRAWN BY
S. N.

CHECKED BY

SCALE	DATE	DRAWING NUMBER	
1 1250	JUNE 67		CBH/10B

COVELL, MATTHEWS AND PARTNERS F/ARIBA A/AMTPI F/FRIAS
ARCHITECTS AND PLANNING CONSULTANTS

7-11 LEXINGTON STREET LONDON W1	01-734-2291
18-20 BOOTH STREET MANCHESTER 2	061-236-8243
12 RUTLAND SQUARE EDINBURGH 1	031-229-3366
14 ST. VINCENT PLACE GLASGOW C1	041-221-4552